


HELMCKEN STREET
868 SM

HOWE STREET

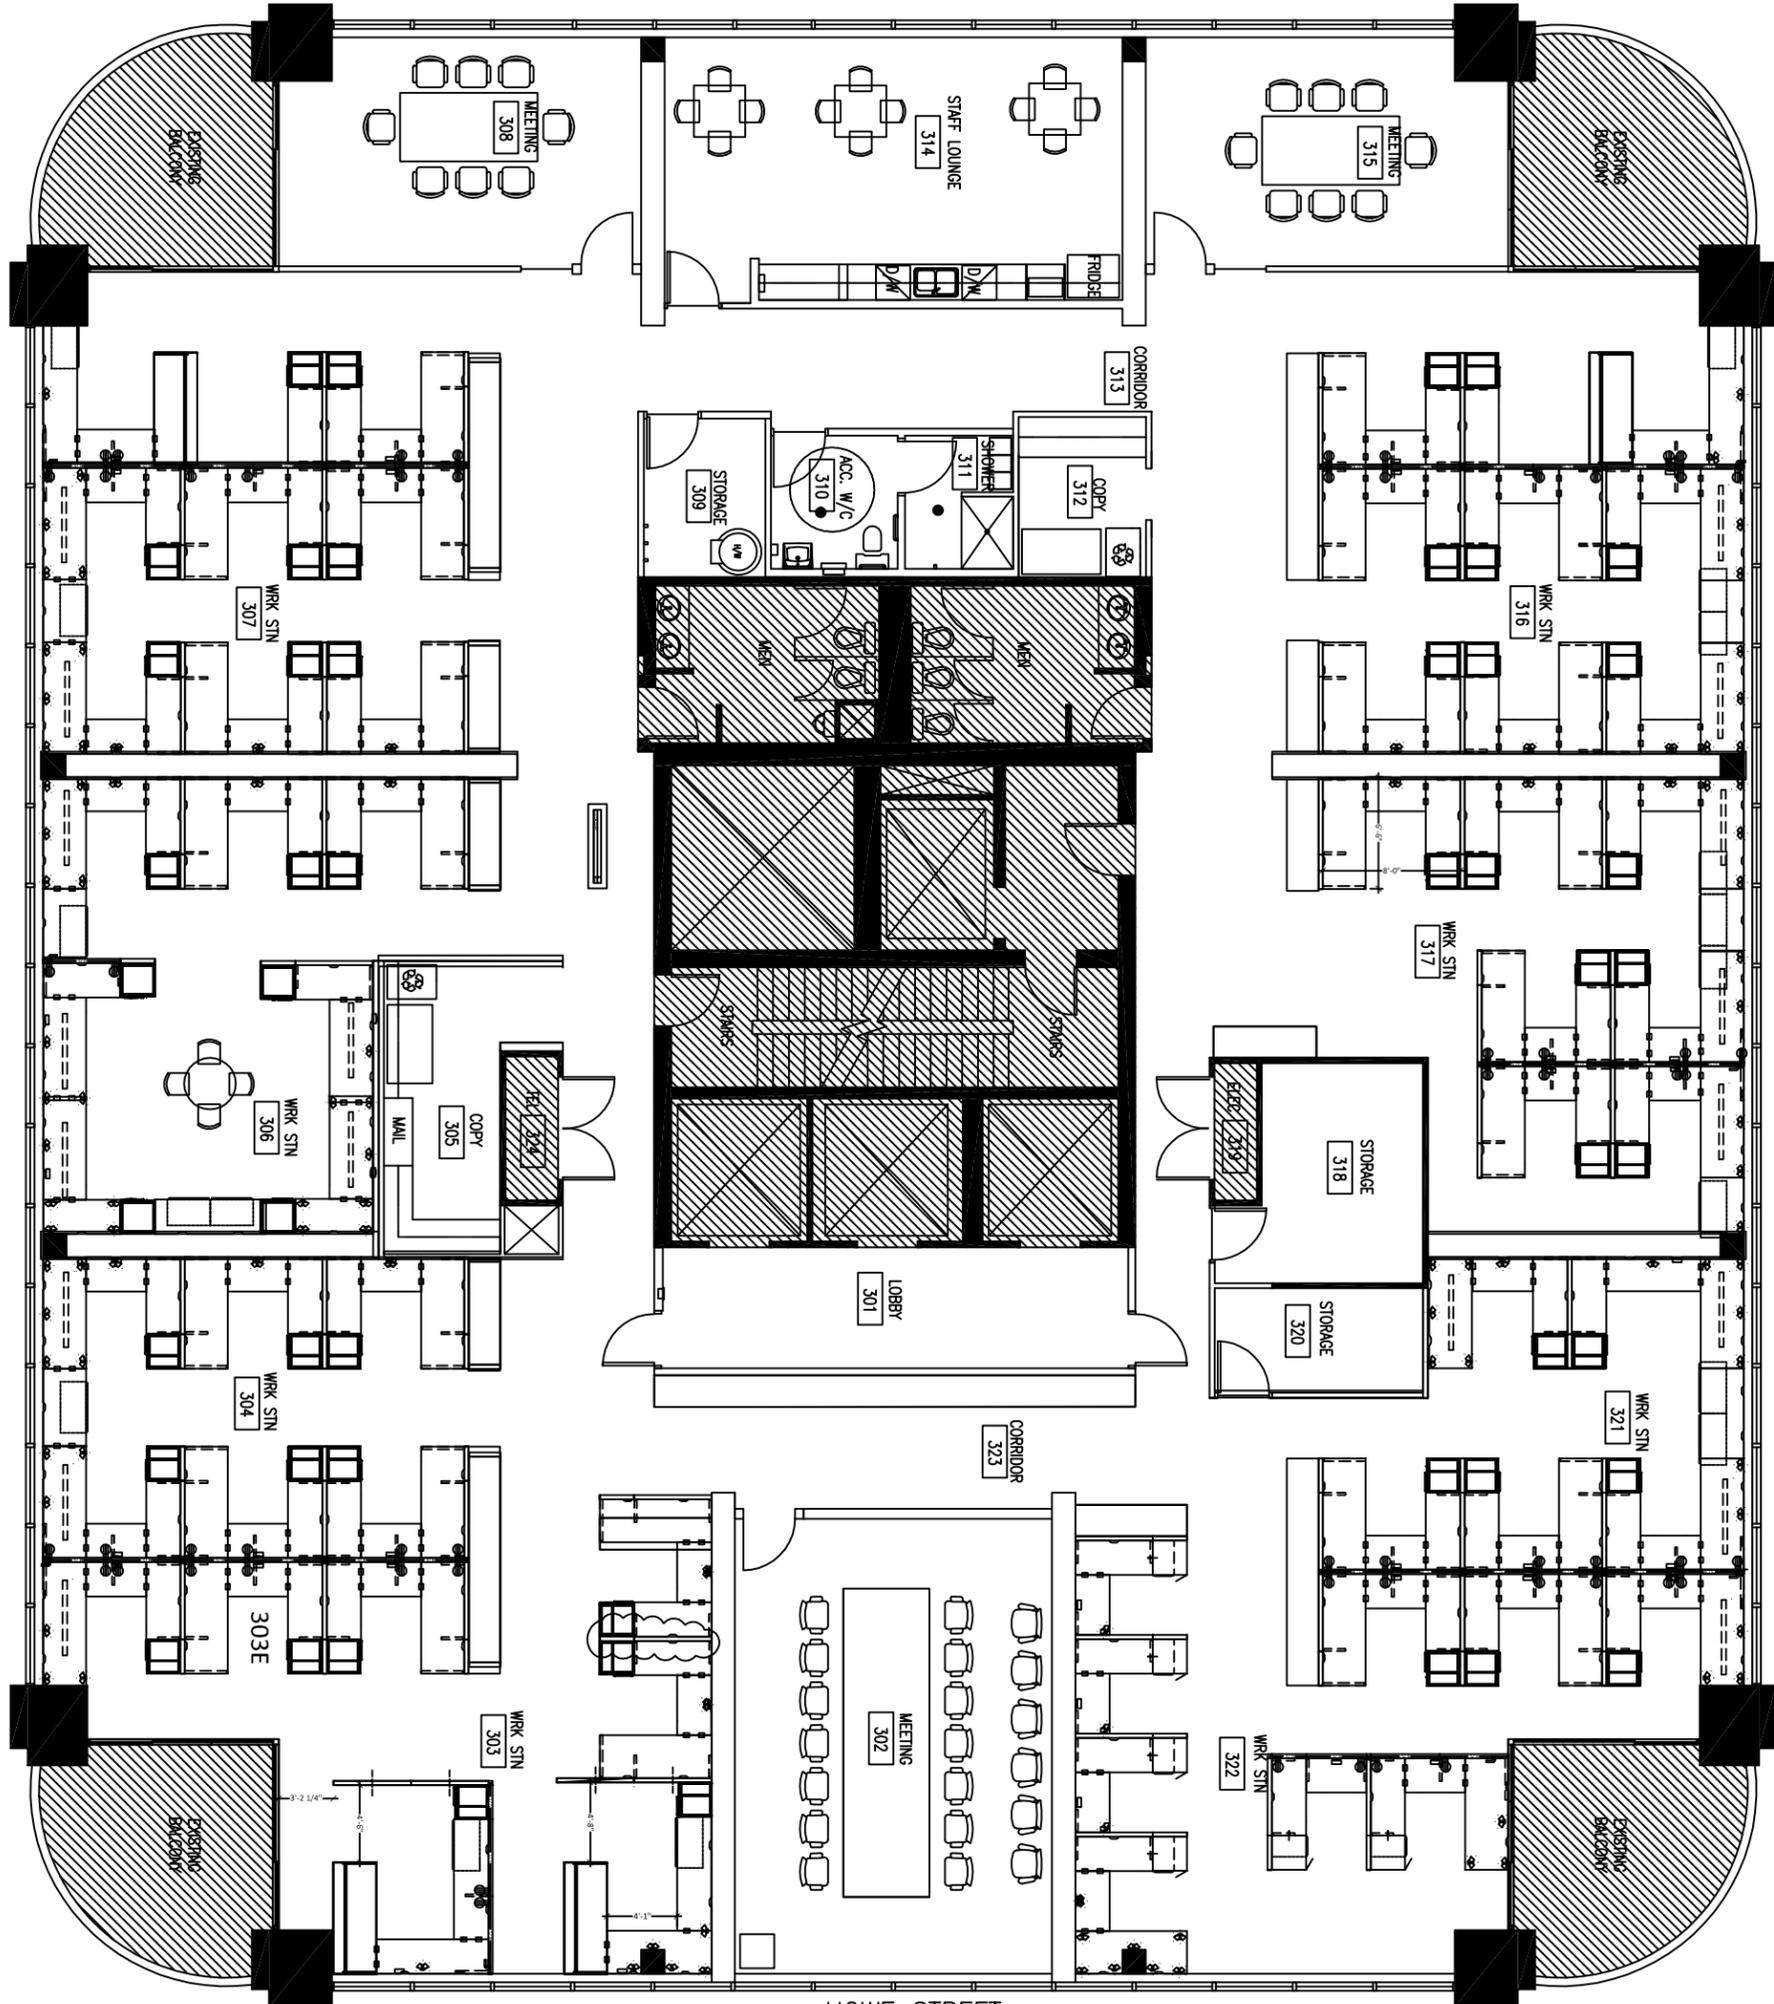

AS-BUILT LAYOUT



1038 Homer Street, Vancouver, B.C. Canada V6B 3J9
T: 604.688.6555 F: 604.688.7544 www.brookscorning.com

Copyright Reserved
This plan and design are, and at all times remain the exclusive property of BROOKS CORNING COMPANY LTD. No part of this drawing may be reproduced, stored in a retrieval system, or transmitted in any form or by any means, electronic, mechanical, photocopying, recording, or by any information storage and retrieval system, without the prior written consent. Written dimensions shall have precedence over scaled dimensions. Customers shall verify and be responsible for all dimensions and conditions on the job and this office shall be informed of any variations from the dimensions and conditions shown on the drawing.

DATE CREATED: 08.18.2011
Revisions:

CUSTOMER SIGN-OFF
The customer and BROOKS CORNING COMPANY LTD. have agreed that the client has verified the drawing and understands that the drawing contains the most recent changes and/or reconfigurations both parties have previously agreed upon.

Date: _____/_____/20____
Name: _____ Part Here _____
Signature: K.

Client: **PROVIDENCE**
1125 HOWE ST
3RD FLOOR

Project Title: **3RD FLOOR**
Drawing Title: **AS-BUILT**
SALES: ASHLEY LOEWEN

Date: 29-SEP-15 Scale: 3/32" = 1'-0"
Drawn By: **BLADES**
Project Number: **1** OF 1